



Nos 560-1-2-3

Profile & Decks

COPY

J L THOMPSON & SONS

NO 560 - S/S - BOSNIA

SUNDERLAND RPT. NO. 29682

CATALINA S. EX THEO \* EX NO 561 - S/S - BACTRIA

SUNDERLAND RPT. NO.

NO 562 - S/S - BOTHNIA

SUNDERLAND RPT. NO.

NO 563 - S/S - BANTRIA

SUNDERLAND RPT. NO. 29765

© 2020

Lloyd's Register  
Foundation

PLANS TRANSFERRED  
TO SISTER VESSEL

\* Captain Manolis M/K

Dis Dec 596

M/K 3336

\*

M/K 3336

00333-00334-0-0074


SS. Nos 560-1-2-3.  
PROFILE & DECK PLAN.

292'0 L.B.P. x 45'0 B.P. EXT x 22'6 DEPTH M.D.

SCALE 1/8" = 1 FOOT.

LLOYDS  
approved plan.

SCANTLING OF HATCHES, BULKHEADS, ETC.  
TO BE SUBMITTED LATER.

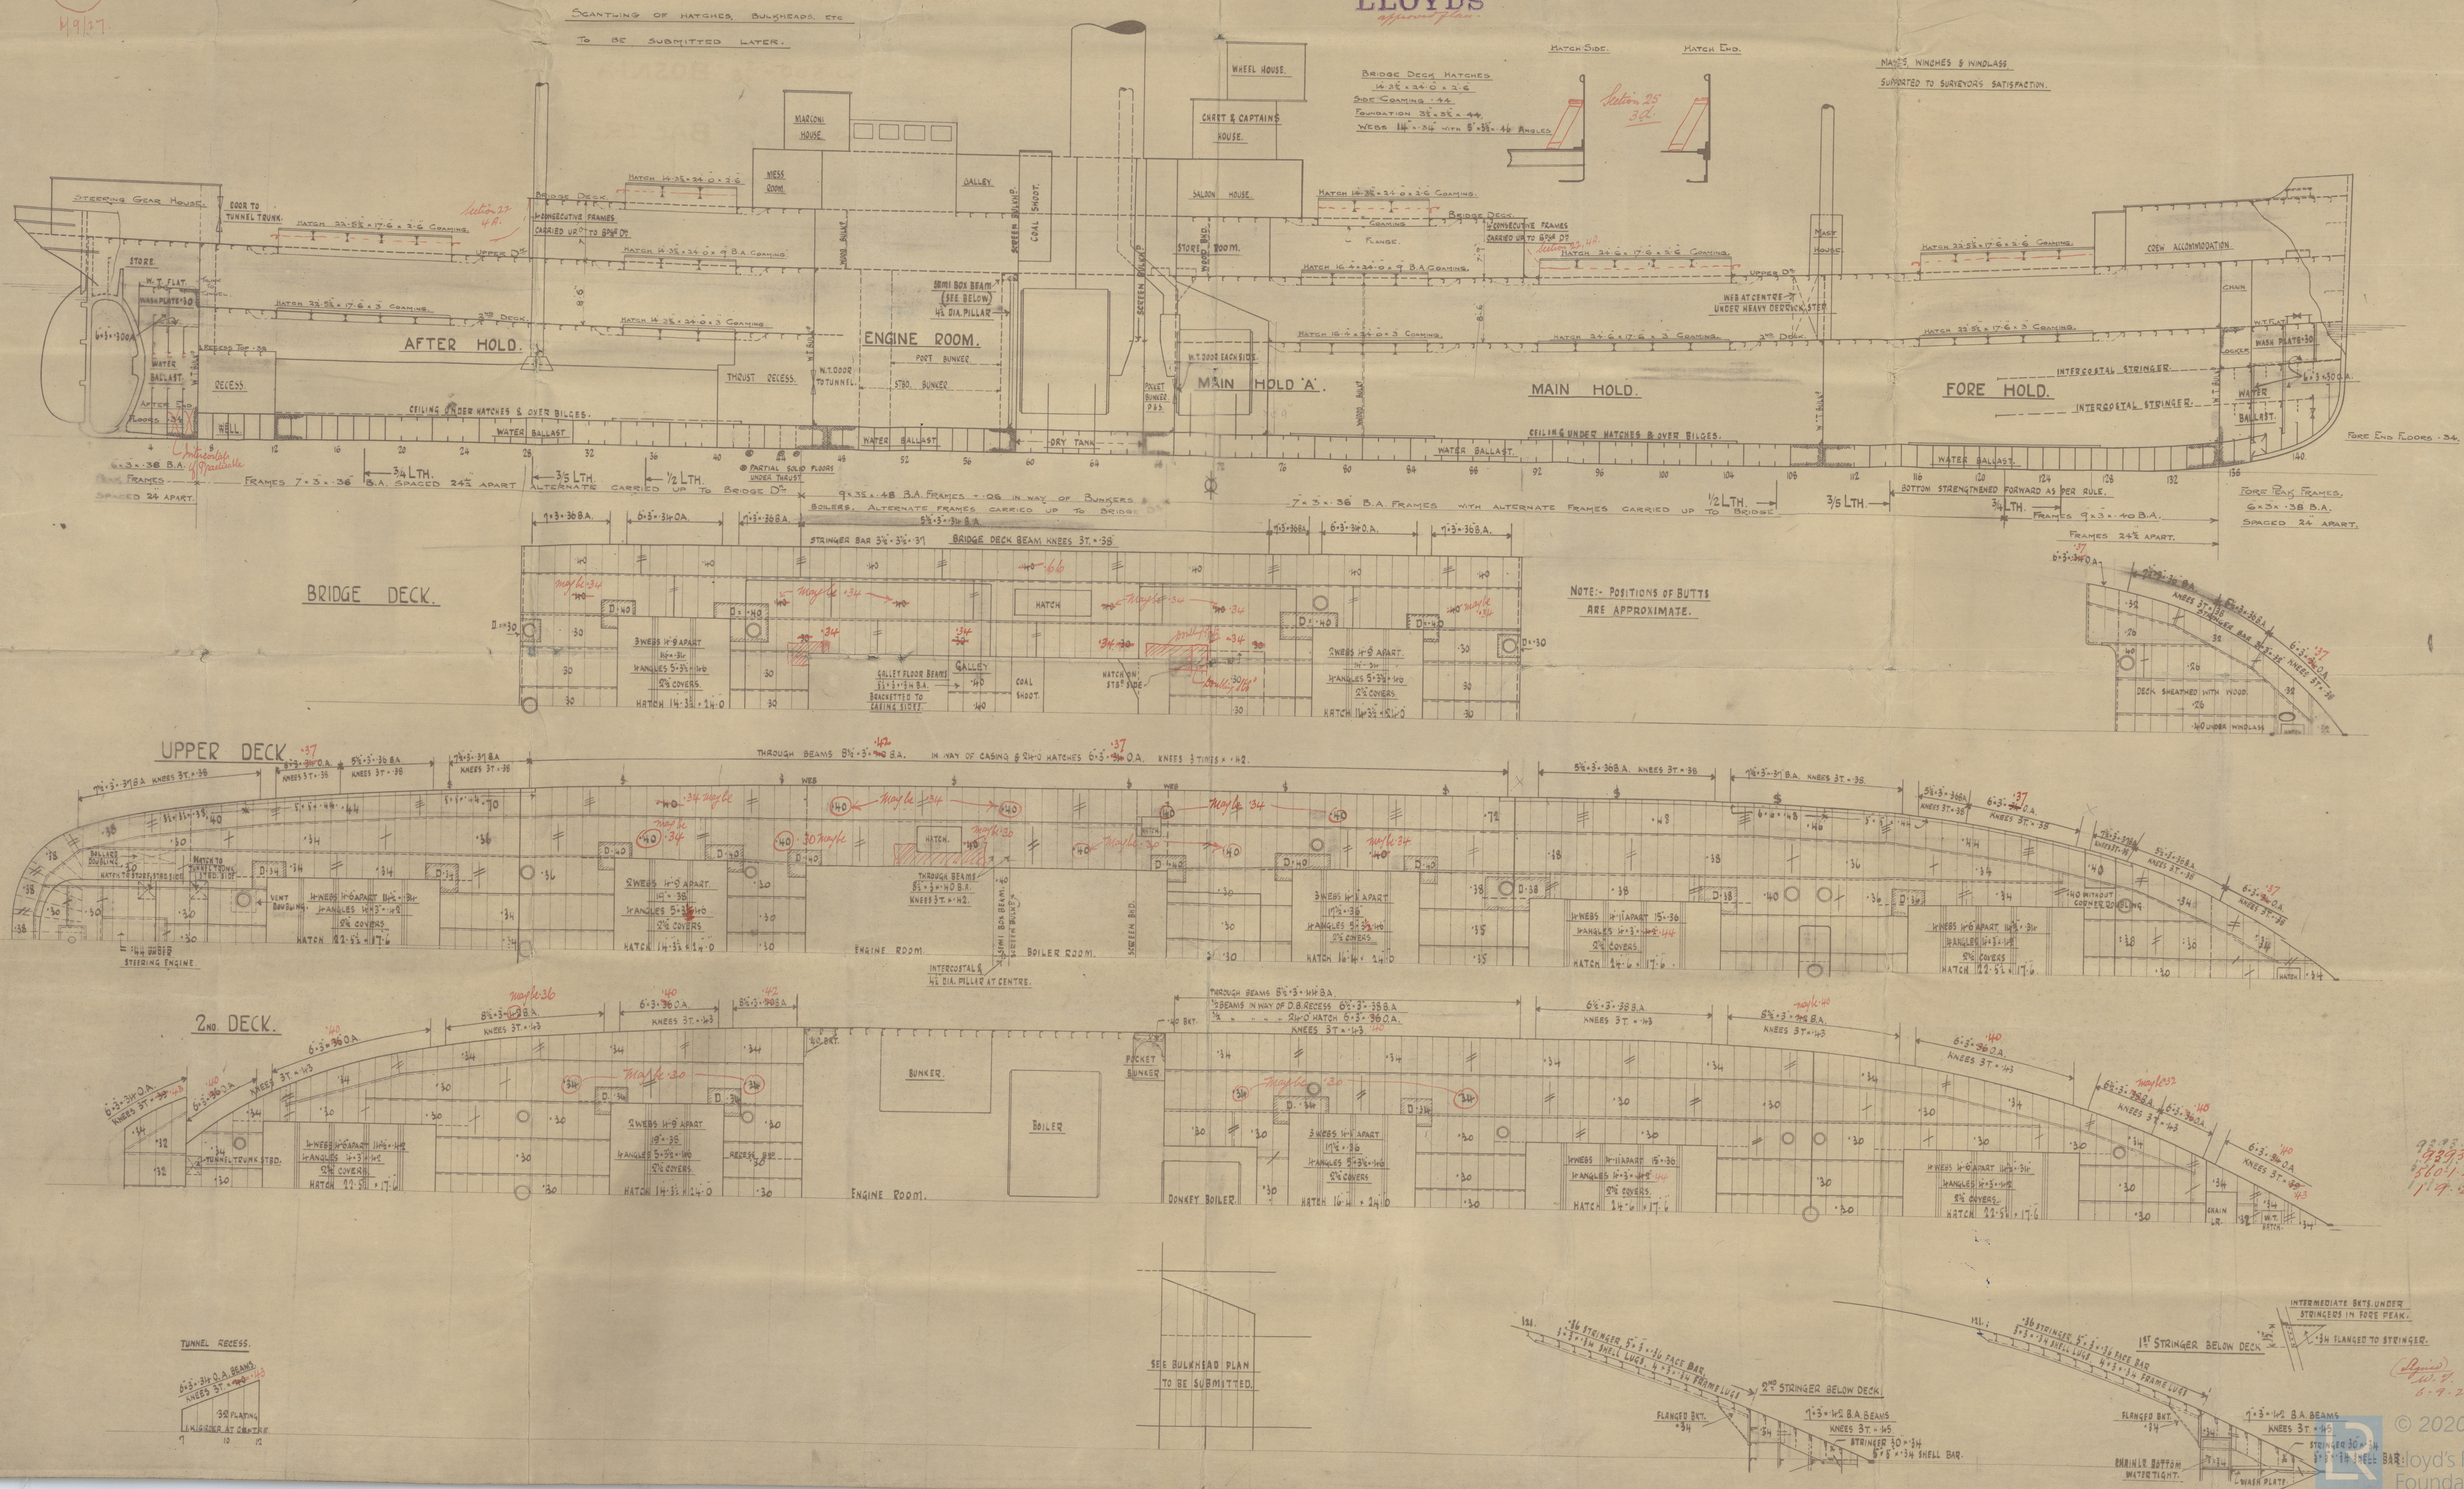

NOTE: POSITIONS OF BUTTS  
ARE APPROXIMATE.

9893.  
560-1-2-3  
119.27.

(Revised)  
11.9.27.

Sunderland.  
L. L. Thompson & Sons.  
- No. 561 -  
"S.S. BACTRIA."  
Profile & Decks.  
(-as built).



SUNDERLAND RPT. No. 29710

PLANS TRANSFERRED  
TO SISTER VESSEL

*Captain Macolis*

M/M 3336  
3336



© 2020

Lloyd's Register  
Foundation  
003333-003340-0072

# S. S. BACTRIA

## PROFILE & DECK PLAN.


292' 0" L.B.P. x 45' 0" B.T. x 22' 6" DEPTH M.O.

SCALE 1" = 1 FOOT.




SCANTLING OF HATCHES, BULKHEADS, ETC.


HAS BEEN SUBMITTED.

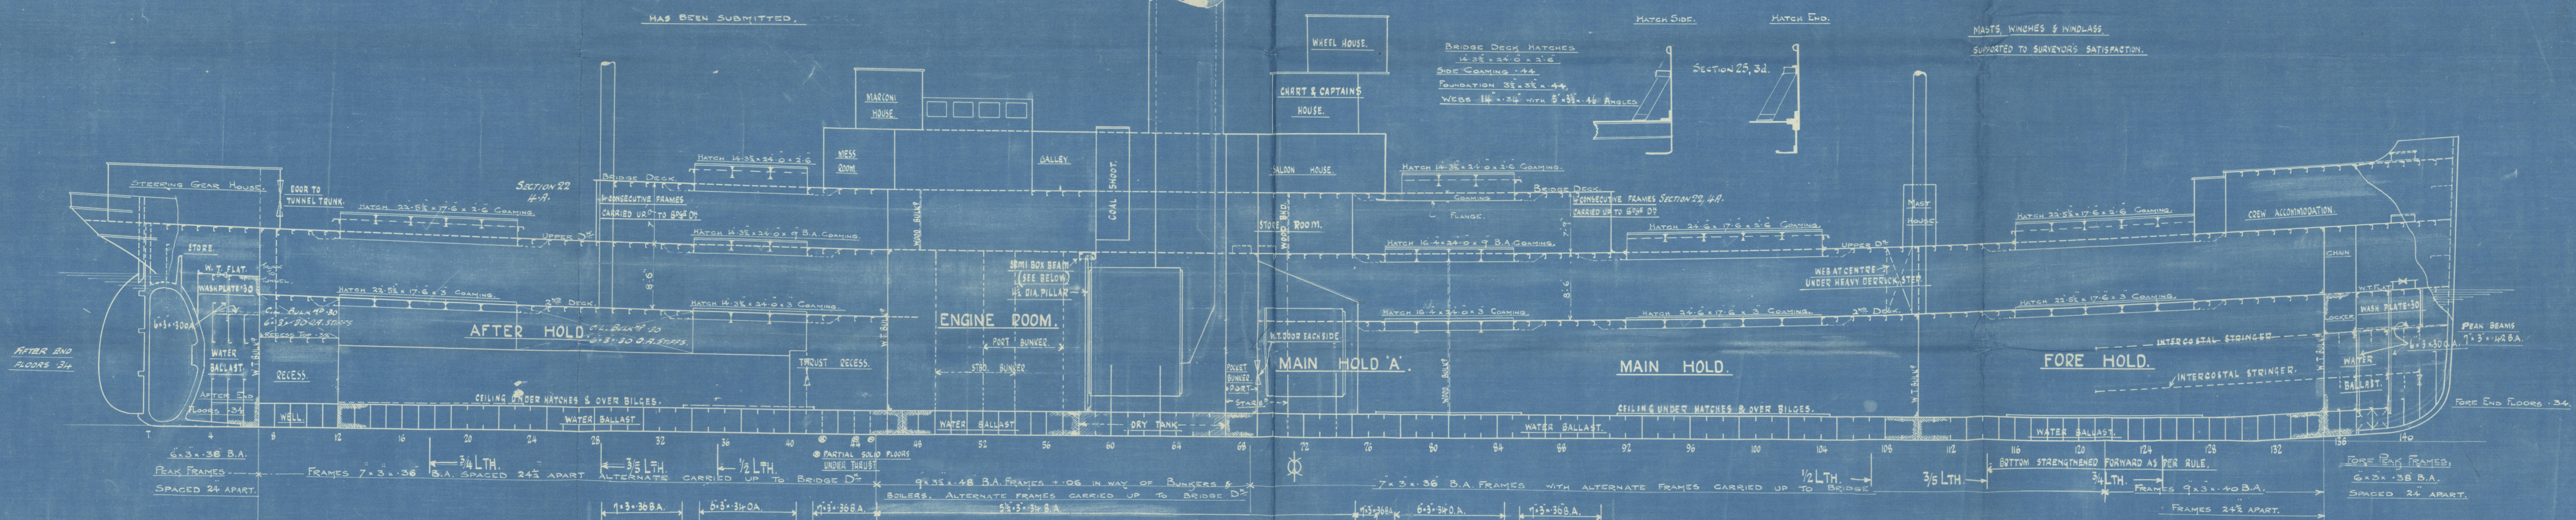


### BRIDGE DECK.

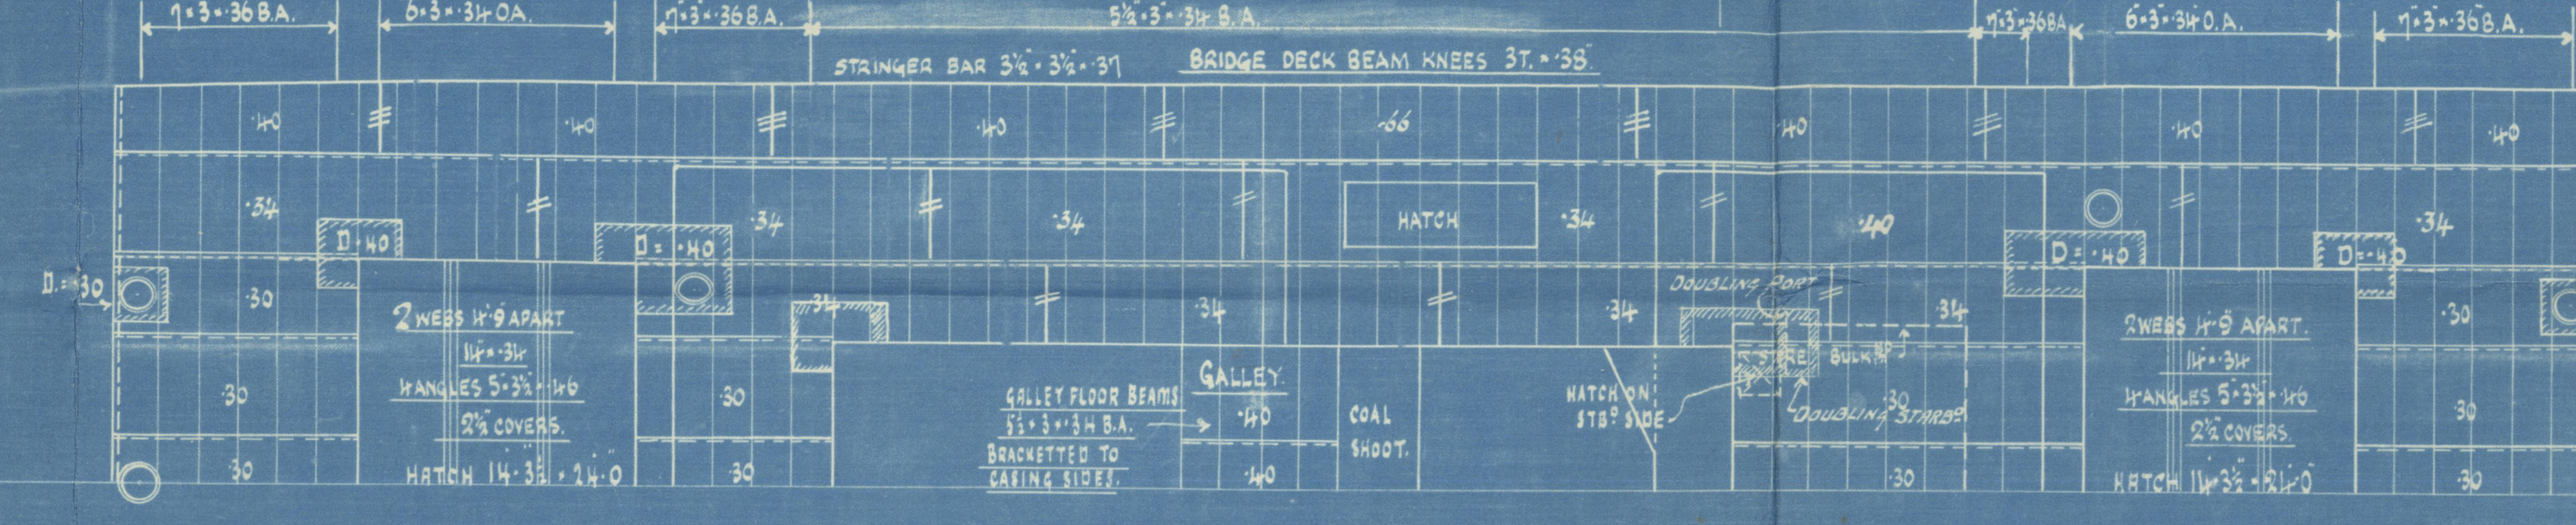

### UPPER DECK.

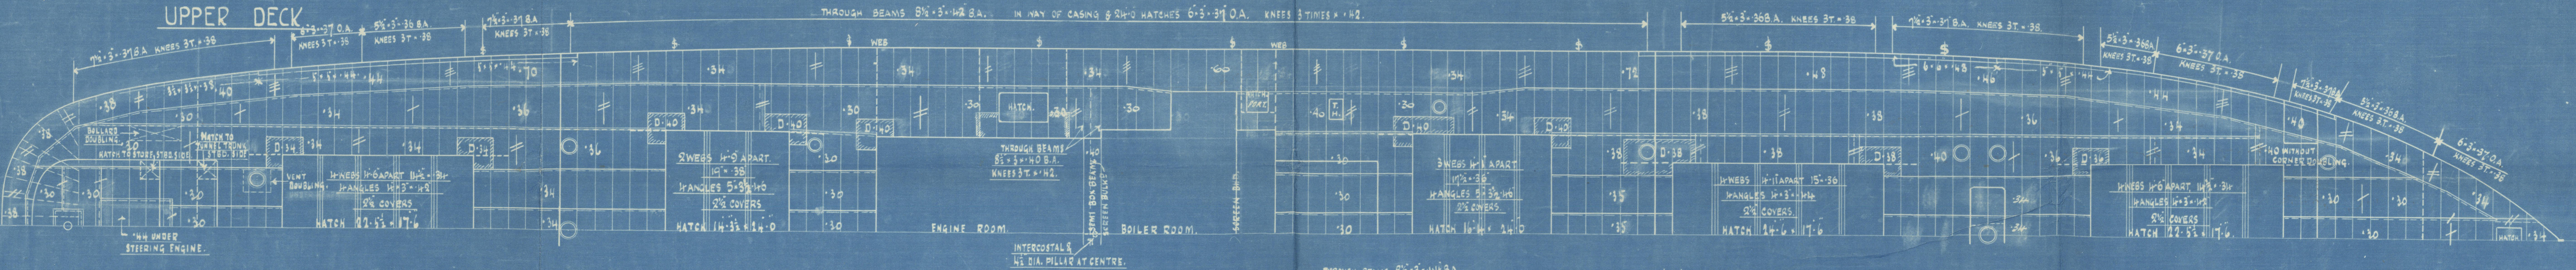


### 2ND DECK.

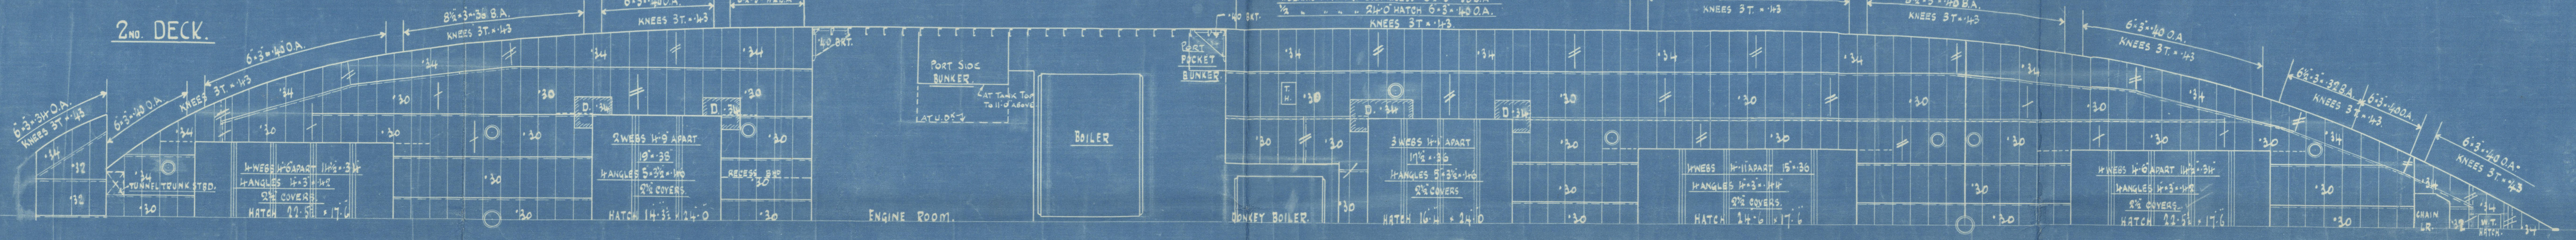

### 5th BULKHEAD PLAN.



### TUNNEL RECESS.

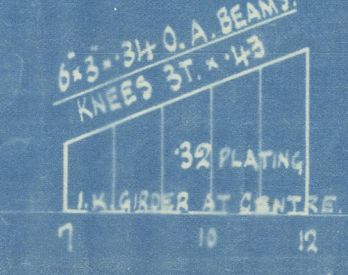

N° 560-1-2-3

MIDSHIP SECTION

COPY OF

**LLOYDS**

APPROVED PLAN.

COPY

J. L. THOMPSON & SONS

No. 560. - s/s "BOSNIA"

SUNDERLAND RPT. NO. 29682

No. 561. - s/s \* BACTRIA  
IN THEO

SUNDERLAND RPT. NO.

No. 562. - s/s "BOTHNIA"  
IN "EMILY"

SUNDERLAND RPT. NO.

No. 563. - s/s BANTRIA

SUNDERLAND RPT. NO. 29764.

PLANS TRANSFERRED <sup>M/M 3336</sup>  
TO SISTER VESSEL

*Leaflet transfer*

**LLOYDS**



© 2020

Lloyd's Register  
Foundation

003333-003340-0075

Lloyds  
Stamp  
6.9.27

PRINCIPAL DIMENSIONS.

LENGTH B.P.	292'0"
BREADTH EXTREME	45'0"
" MOULDED.	44'6"
DEPTH MID UPPER DK.	22'6"
DEPTHS TO LENGTH (UPPER DK.)	12'98
" " (BRIDGE)	9'65

MIDSHIP SECTION.  
S.S. Nos 560.1.2.3.  
LLOYDS 100 A.I. CLASS.  
Scale 1/2" = 1 FOOT.

LLOYDS

Controlled by Lloyds.


NUMERALS.

D. 22.5	d. 11.2
D.L. (22.5 x 292)	6570.
(B+D) x L (44'5" x 292)	19637.
ERECTOR'S	55% OF L

EQUIPMENT NUMERALS.

(B+D) x L	19637.
BRIDGE 18.62 x 7.75 x 75	748.
FORECASTLE 38.33 x 7.75 x 75	187.
CASING ETC 7.45 x 7.5 x 5	268.

EQUIPMENT No 20840.

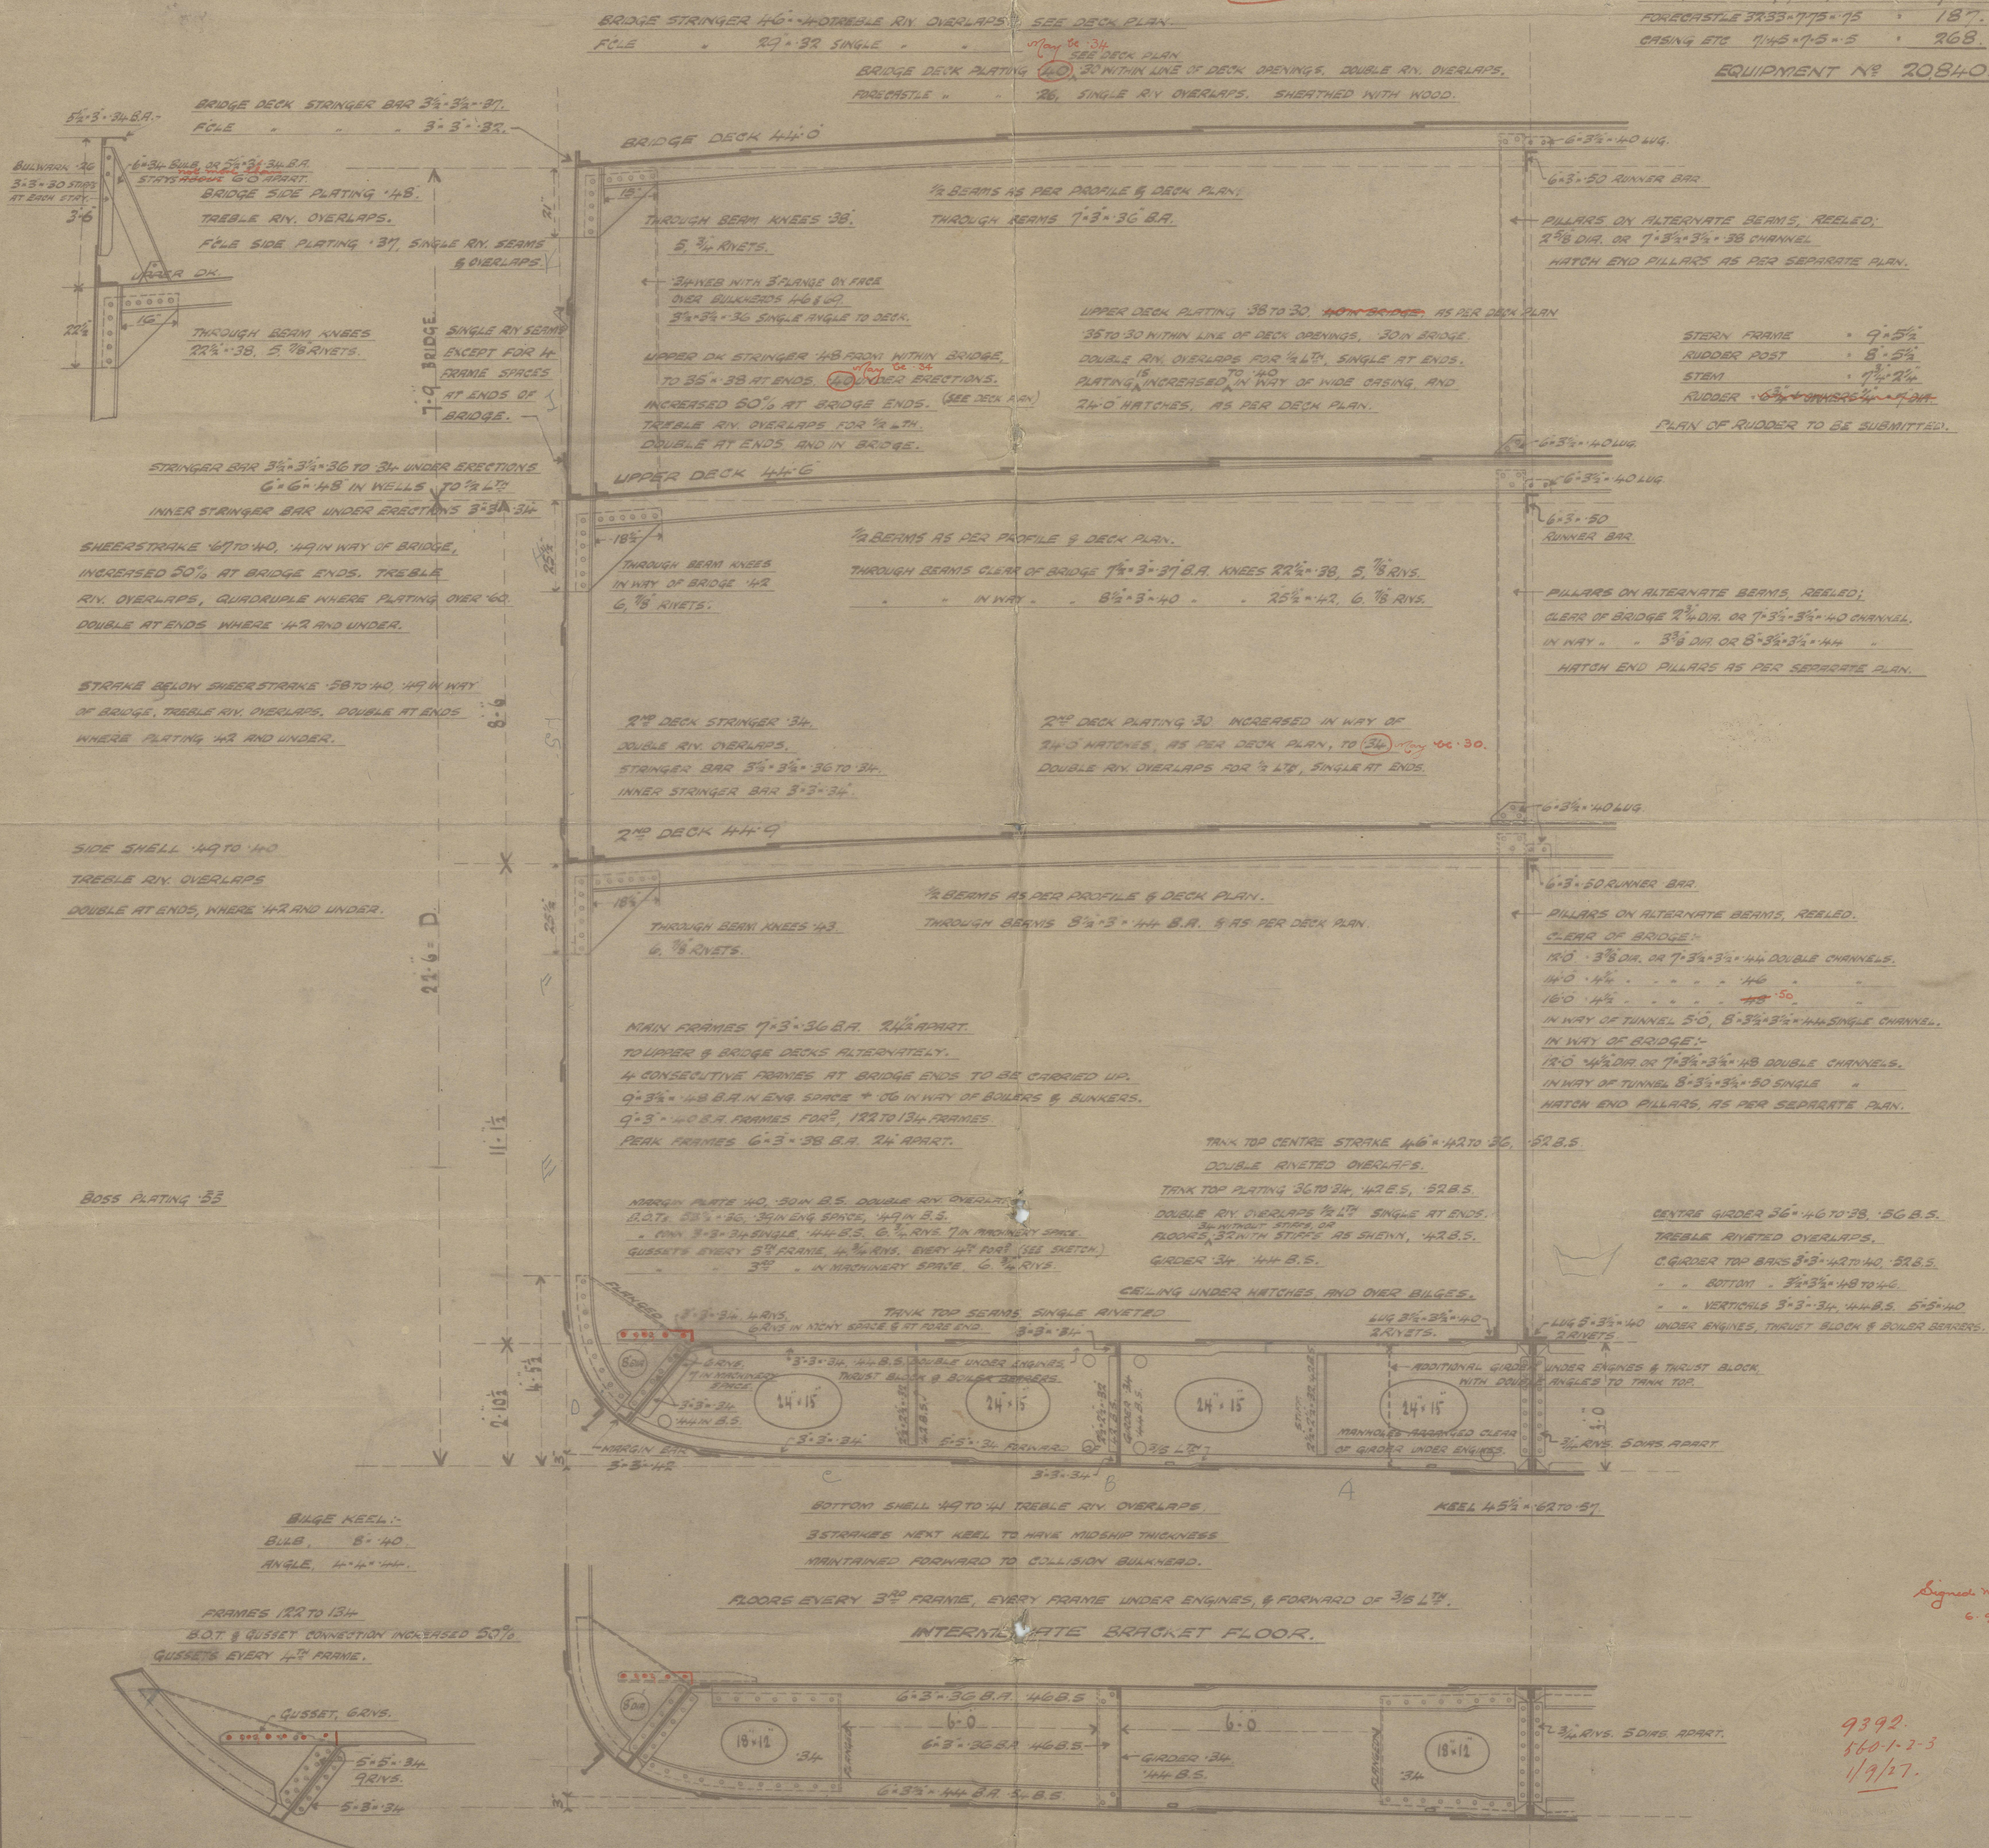

Controlled by Lloyds.  
6.9.27

9392.  
560.1.2.3  
1/9/27.

Sunderland.

J. L. Thompson & Sons.

- N<sup>o</sup>. 561 - M/M 3336

S.S. "BACTRIA."

Midship Section.

(-as built)



SUNDERLAND RPT. NO. 29710.

~~PLANS TRANSFERRED  
TO SISTER VESSEL~~

~~Capetan~~

~~Manolis~~



© 2020

Lloyd's Register  
Foundation

005333-005340-0073

**LLOYDS 100 A.I. CLASS.**

scale  $\frac{1}{2}$ " = 1 Foot.

PRINCIPAL DIMENSIONS.

LENGTH B.P.	"	199.0"
BREADTH EXTREME,	"	45.0
" MOUNDED,	"	44.9
DEPTH MILD UPPER DK.	"	22.6
DEPTHS TO LENGTH (UPPER DK.)	"	19.98
" " " (BRIDGE)	"	9.65

## NUMERALS.

$$\begin{aligned} D &= 22.5' & d &= 11.2 \\ D \times L &= (22.5 \times 292) & &= 6570 \\ (B+D) \times L &= (44.75 + 22.5) \times 292 & &= 19637 \\ \text{ERECTIONS} &= 55\% \text{ OF } L \end{aligned}$$

EQUIPMENT NUMERALS.

$(B+D) \times L$	=	19637
BRIDGE 128.62 $\times$ 7.75 $\times$ .75	=	748.
FORECASTLE 28.25 $\times$ 7.75 $\times$ .75	=	164.
CASING ETC 71.45 $\times$ .75 $\times$ .5	=	268.

EQUIPMENT № 20817.

Sunderland

J. L. Thompson & Son.

Nos 560-1-2-3.

Pumping Arrangement.

N<sup>o</sup> 560-s.s. "BOSNIA"

SUNDERLAND RPT. NO. 29682

N<sup>o</sup> 561-s.s. BACTRIA

W. Theo

N<sup>o</sup> 562-s.s. "BOTHNIA"

N<sup>o</sup> 563-s.s. BANTRIA

SUNDERLAND RPT. NO. 29764

- COPY. -

PLANS TRANSFERRED  
TO SISTER VESSEL

Capetan Manolis

M/M 8597

00 8597 - 008607 - 0030

Lloyds Register  
Foundation

292 O LBP - 45' 0" B<sup>TH</sup> EXT - 22' 6" D<sup>TH</sup> M<sup>TH</sup>

AIR PIPES TO HAVE GOOSE-NECK TOPS & SOUNDING PIPES TO HAVE BRASS DECK FITTINGS NEARLY  
FITTED INTO DECK, & CASED IN WITH WOOD IN THE HOLDS.

A hand-drawn diagram of a ship's hull cross-section, focusing on the forepeak area. The diagram is drawn on a blue background with white lines and text. A vertical centerline runs through the middle of the hull. The hull shape is roughly triangular, tapering to a point at the bottom. Inside the hull, a rectangular structure is labeled "CHAIN LOCKER, WATERTIGHT BELOW 1000K.". To the right of this structure, a vertical line represents a scupper, labeled "2ND DK SCUPPER". A horizontal line connects the chain locker to the scupper, labeled "ROTARY HAND PUMP ON FCLE END, UPPER DK.". At the top of the scupper, there is a circular symbol with a cross inside, labeled "FCLE D.K.". Below the scupper, a horizontal line is labeled "PEAK FLAT DRAIN TO CHAIN L.R. P.A.S.". At the bottom of the scupper, there is a small rectangular structure labeled "STGR.". The bottom of the hull is labeled "FORE PEAK TANK".

560. 1. 2. 3.

Rudder Plan.

Copy of

**LLOYDS**

Approved plan.

J. L. Thompson & Sons.

No. 560. - 8/s "BOSNIA"

SUNDERLAND RPT. NO. 29682

No. 561. - "BACTRIA" \*

SUNDERLAND RPT. NO.

No. 562. - "BOTHNIA"

SUNDERLAND RPT. NO.

No. 563. - "BANTRIA"

SUNDERLAND RPT. NO. 29764.

**PLANS TRANSFERRED  
TO SISTER VESSEL**

*Capetan*

*N/W manolis \**

**M/M 8597**

**R**

Lloyd's Register

008597 - 008607 - 0031

2-11-27.

Copy of  
LLOYDS

Approved & laud

$$\left. \begin{array}{l} \text{A. } 74 \times \text{D. } 2.71 = 200.5 \\ \text{SPEED} \parallel \text{KNOTS} \end{array} \right\} = 6\frac{3}{4}'' \text{ RULE DIA.}$$


$$+ \frac{1}{4}'' \text{ OWNERS} = 7'' \text{ DIA.}$$

INCREASE ON FORGING ONLY.


### DETAIL OF COUPLING

SCALE  $\frac{1}{2}'' = 1 \text{ FOOT.}$


RUDDER:- SCALE  $\frac{1}{2}'' = 1$  FOOT.

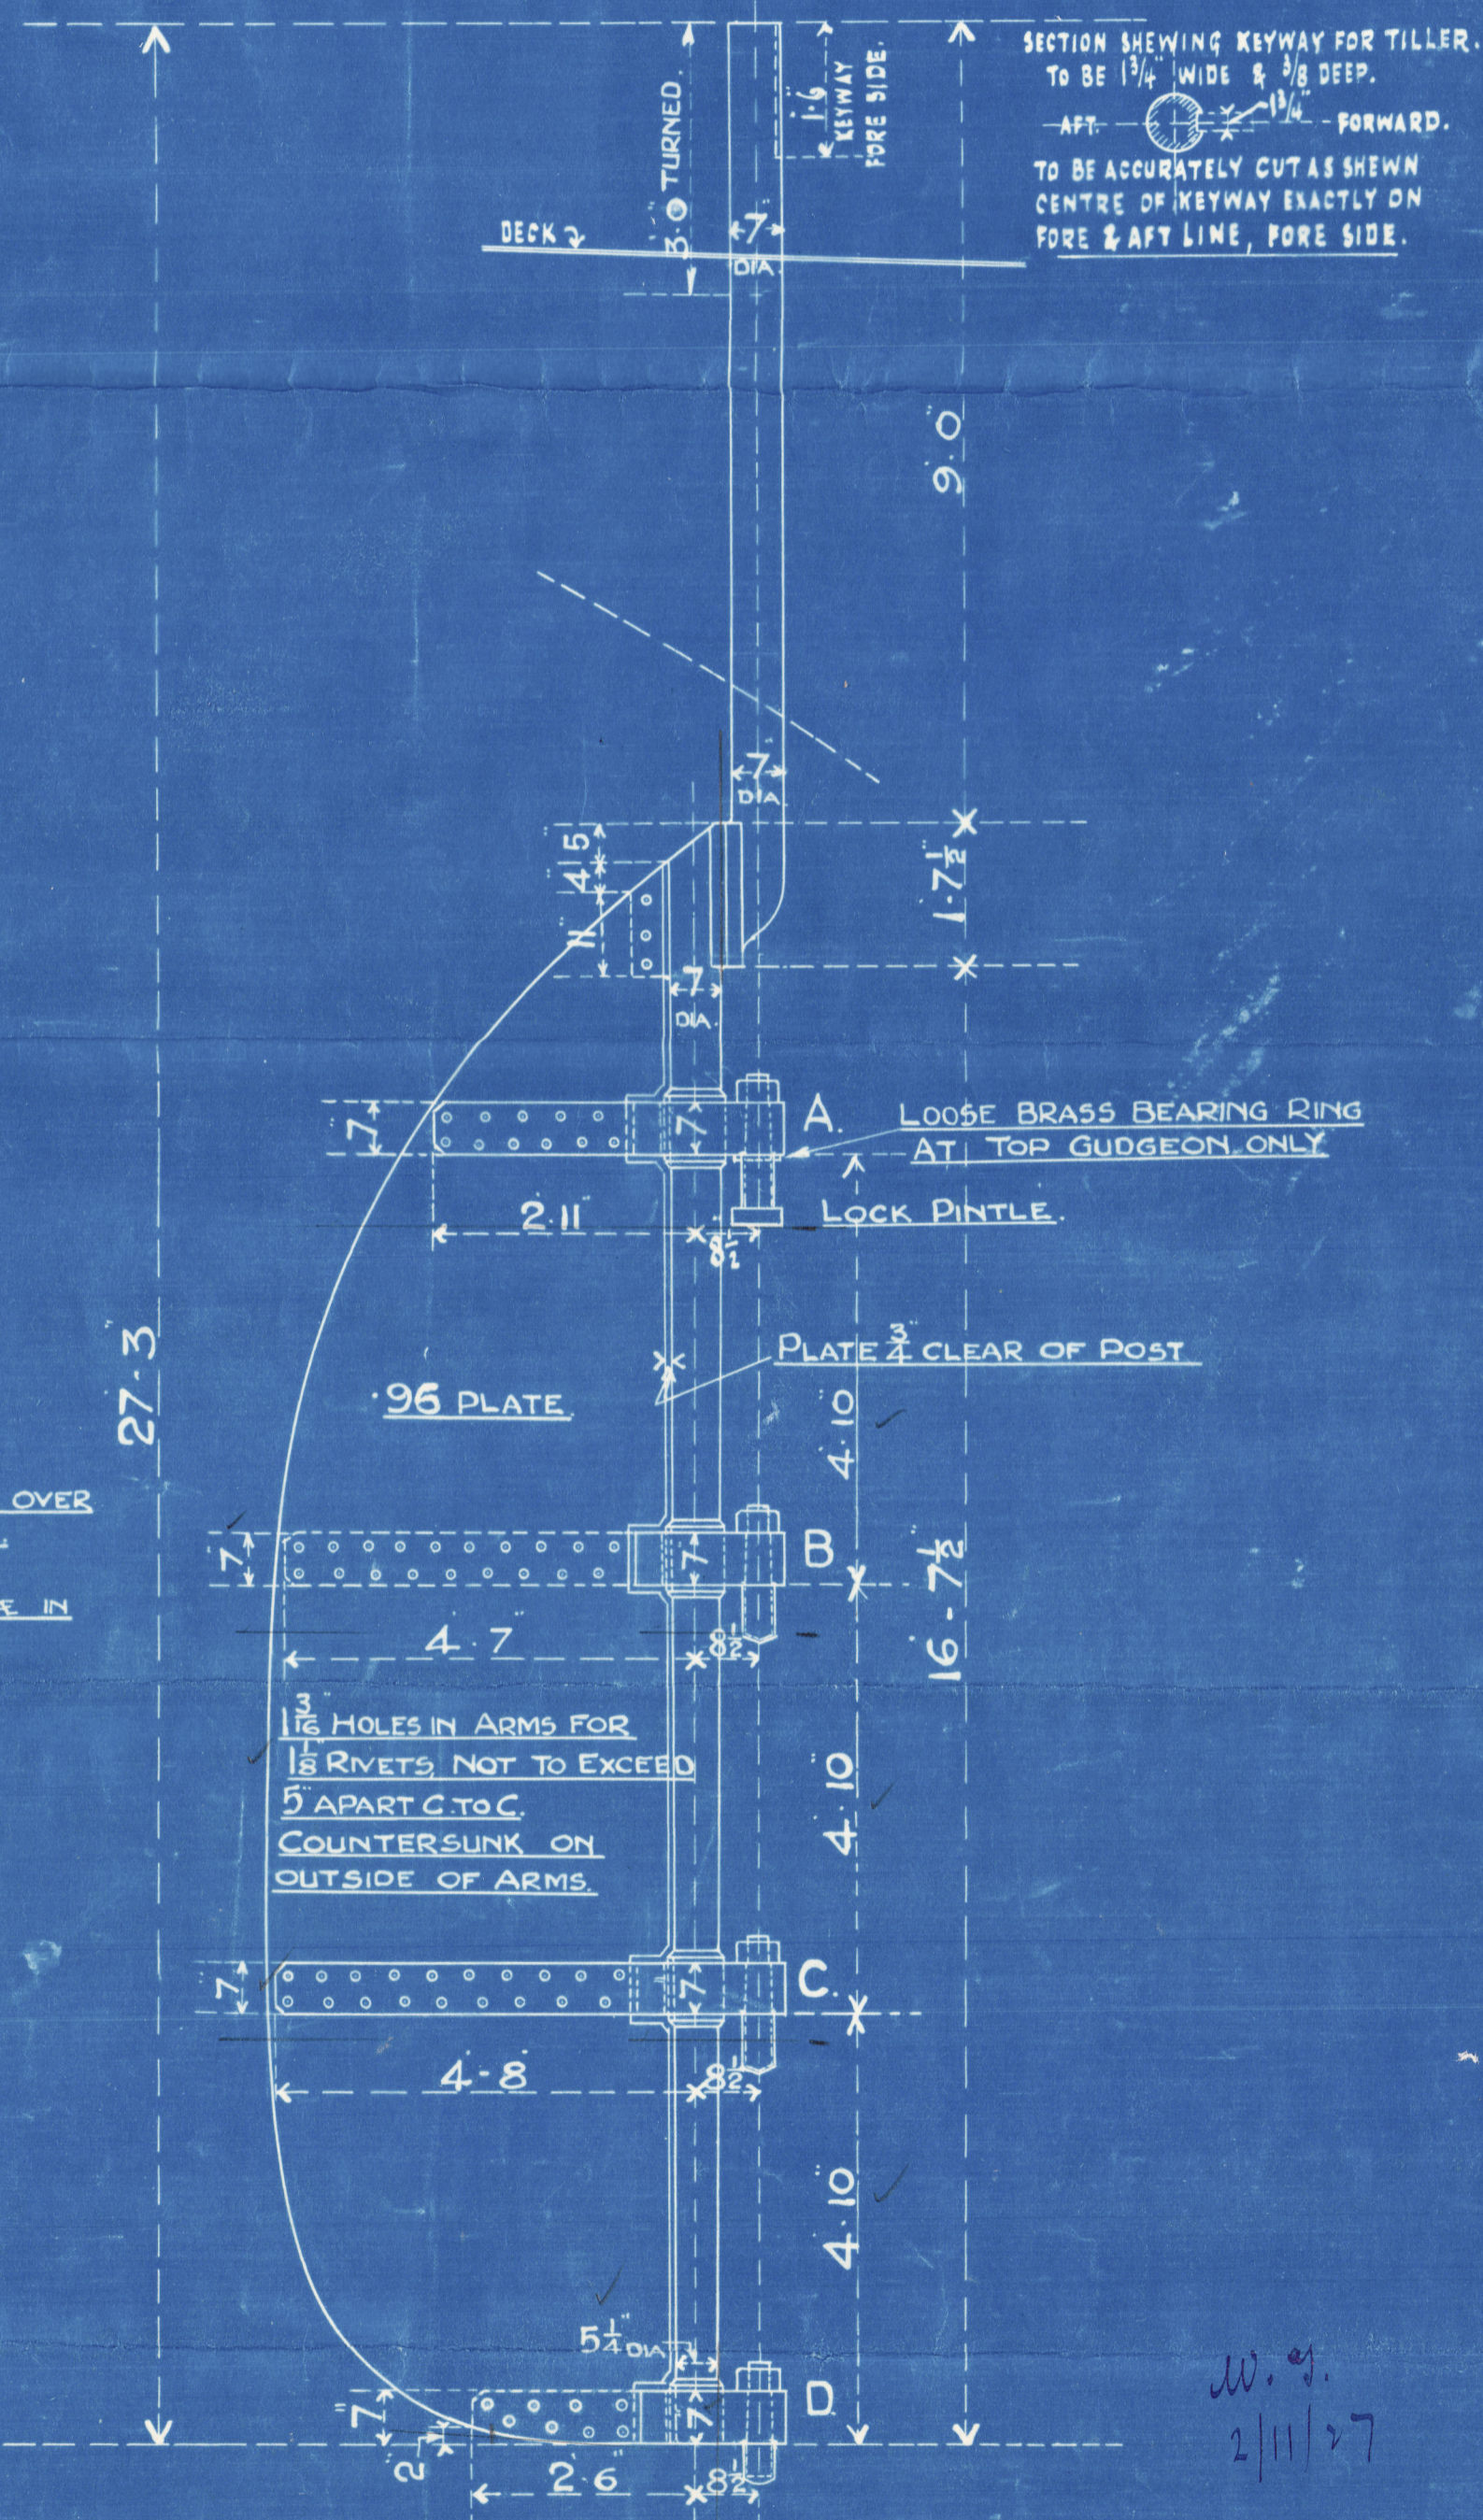

### PLAN OF RIGHT HANDED ARM.

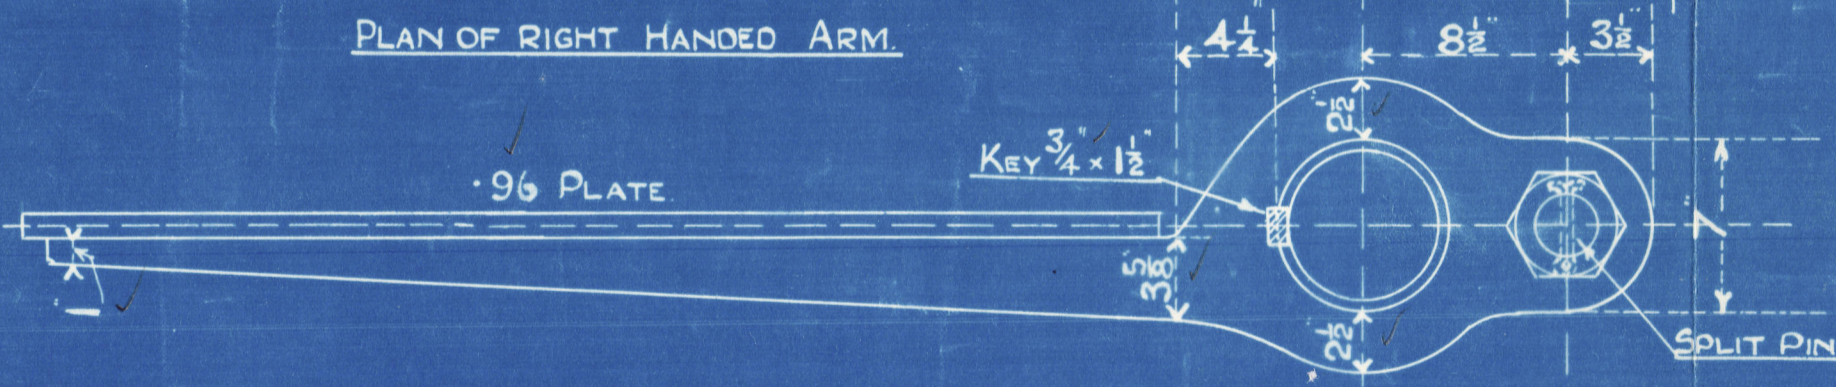

DETAIL OF BOTTOM PINTLE D.

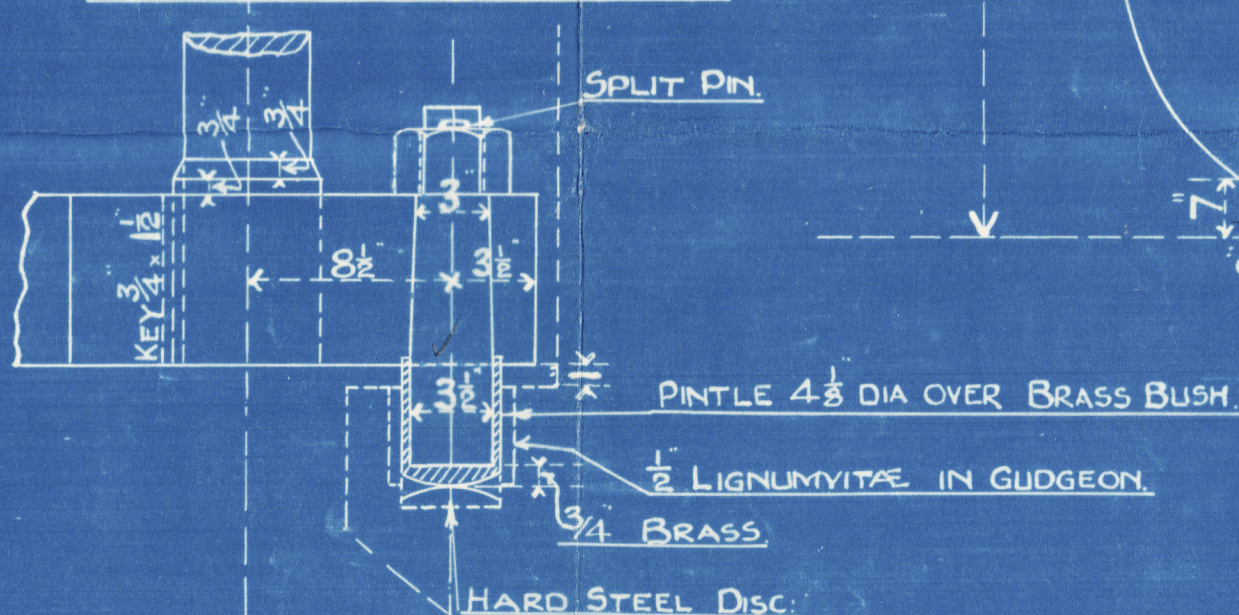

POST INCREASED  $\frac{3}{4}$ " IN DIA IN WAY OF ARMS  
TO ALLOW KEYWAY TO BE CUT CLEAR OF  
MAIN PIECE AS SHOWN.

SPACING OF ARMS & DEPTH, & DIA OF HOLES  
IN GUDGEONS FOR PINTLES TO BE CHECKED FROM  
STERN FRAME.

W. G.  
2/11/27

9430

560.1-2-3.22

21.10.27

008597 - 008607 - 0031